


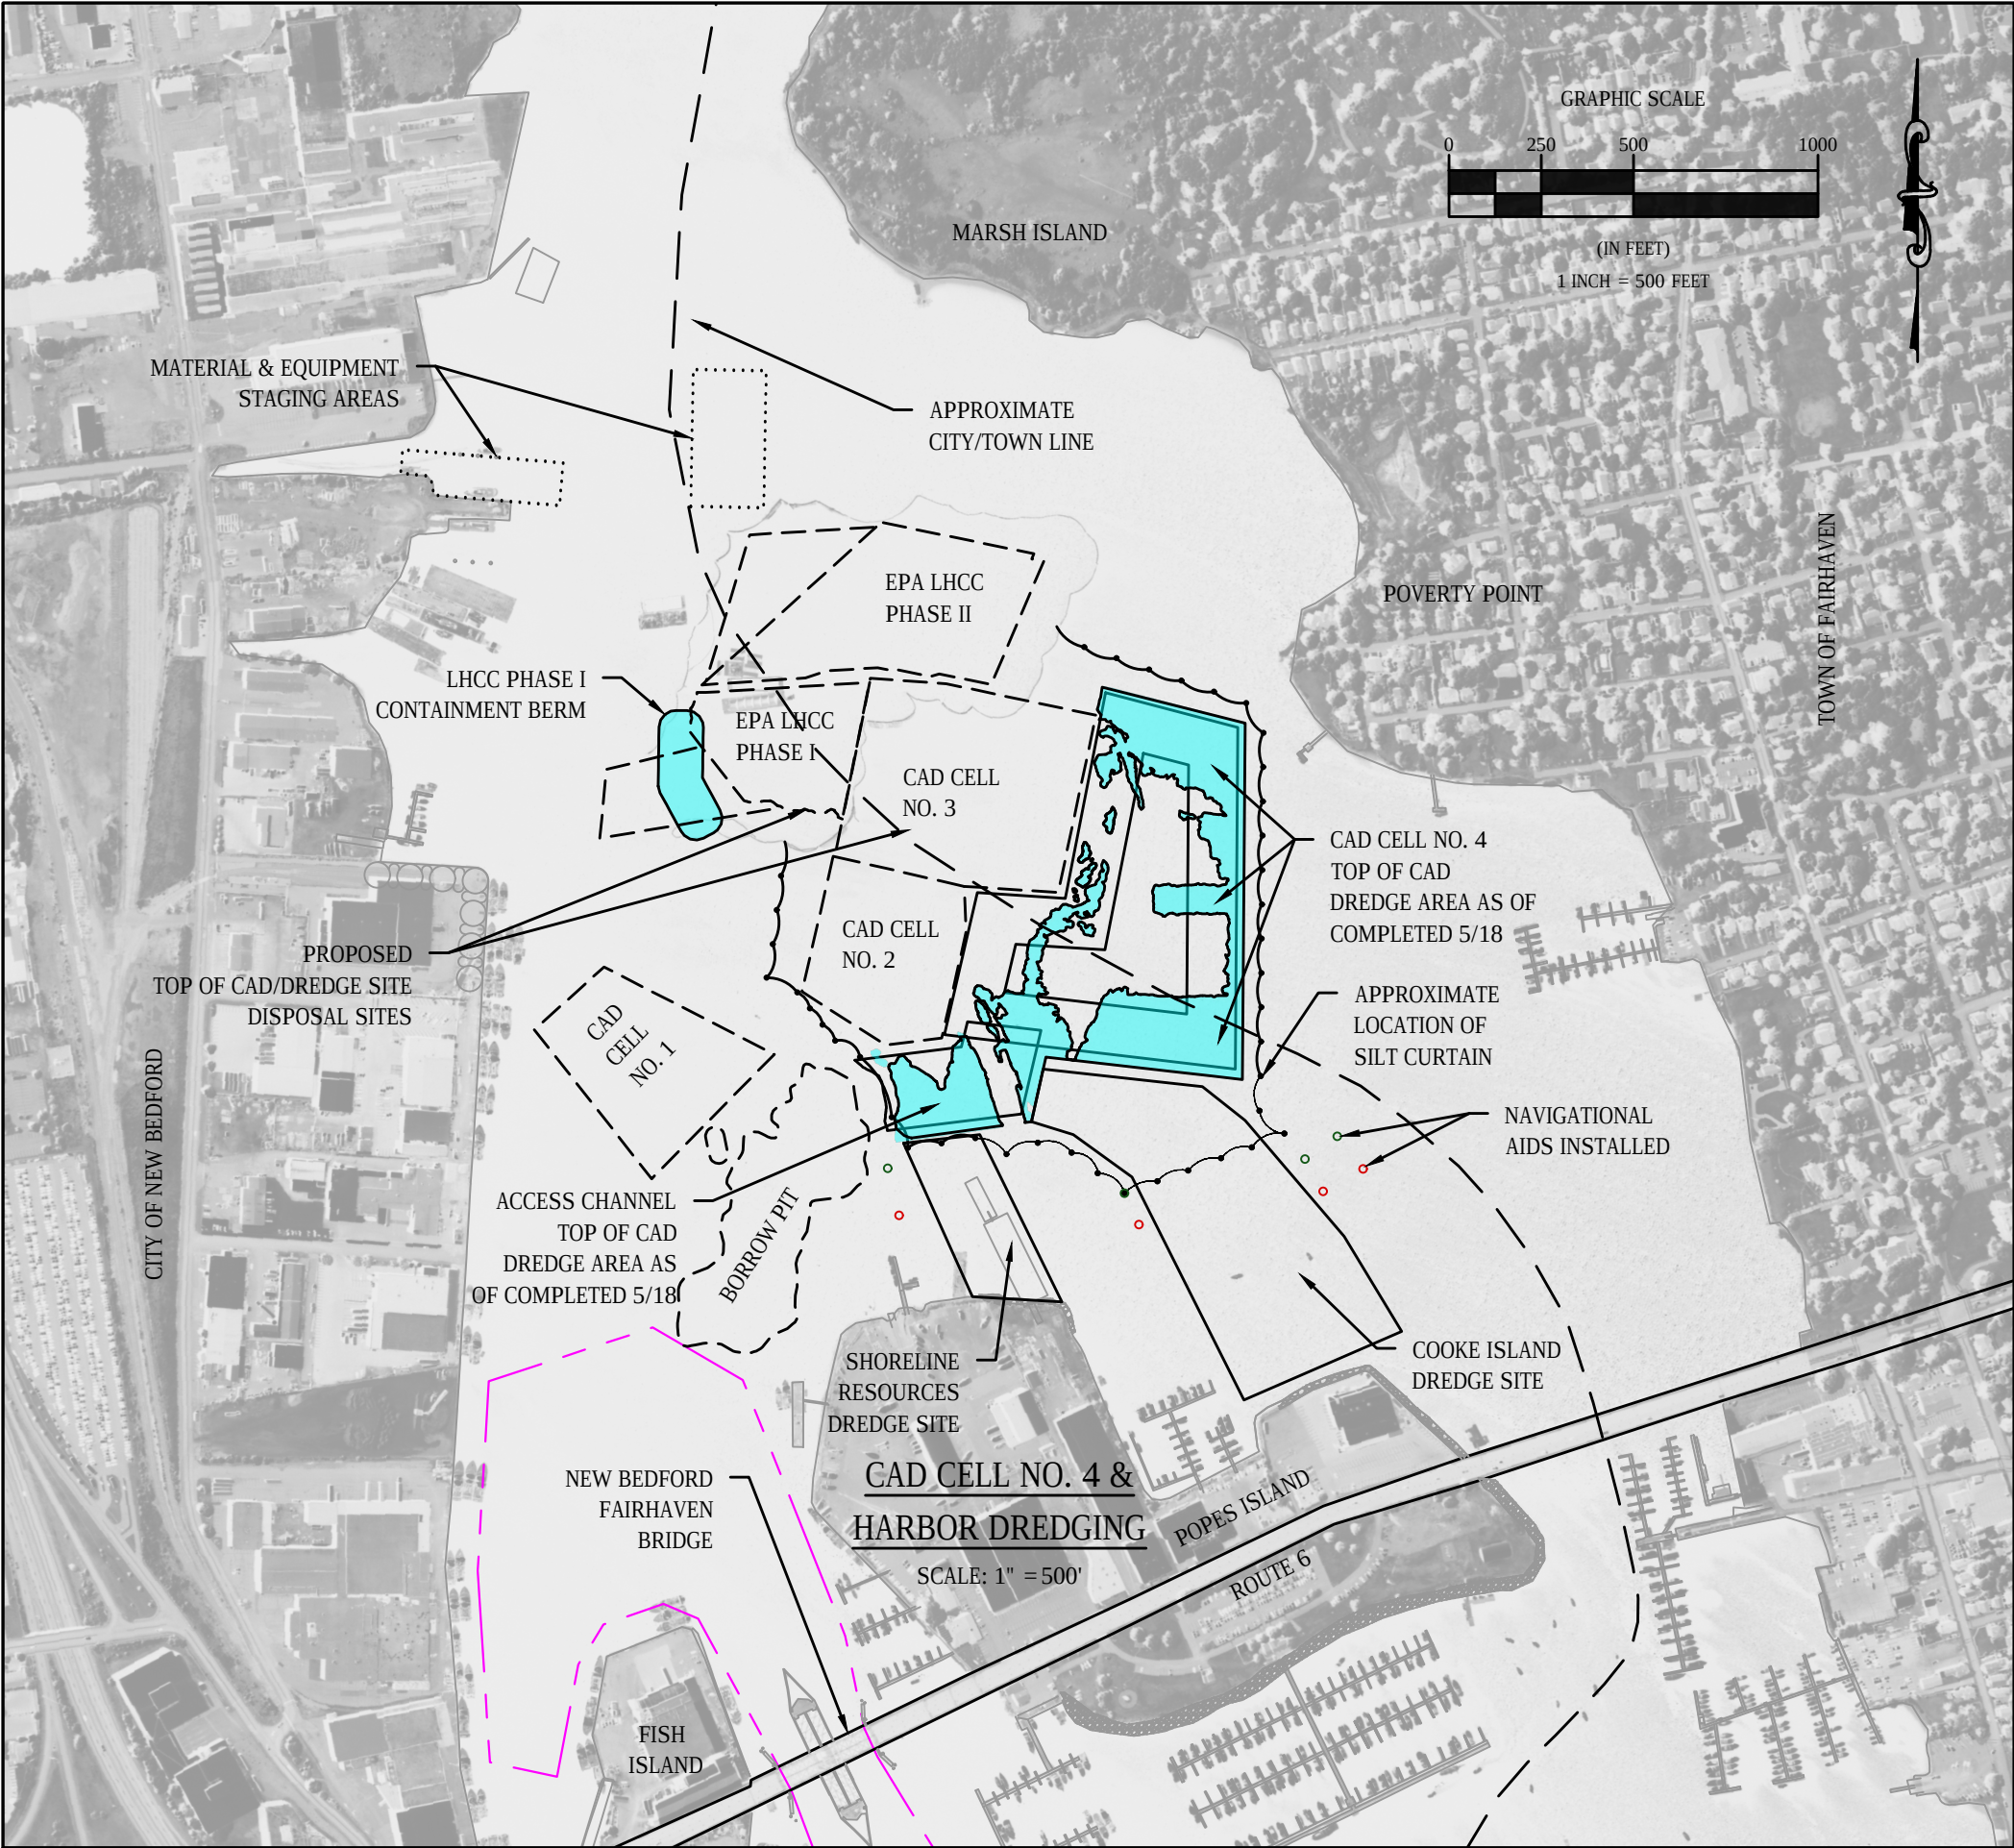

LEGEND:

AS BUILT LIMIT OF EXISTING
CAD CELLS & ACCESS CHANNEL

TOWN/CITY LINE

LIMIT OF FEDERAL CHANNEL

TOP OF CAD DREDGE AREA
COMPLETED AS OF 5/18/2020

VOLUME TABLE:

TOP OF CAD/CAD CELL DISPOSAL
VOLUME REMOVED:
27,650 CY

MIDDLE OF CAD/OFFSHORE DISPOSAL
VOLUME REMOVED:
0 CY

EQUIPMENT ONSITE:

DREDGE WOOD 1 - CASHMAN MARINE
WORK AREA
TOP OF ACCESS CHANNEL
SOUTH/SOUTHEAST END OF CAD CELL NO. 4

DREDGE TRITON - AGM MARINE
WORK AREA
TOP OF ACCESS CHANNEL
NORTH/NORTHEAST END OF CAD CELL NO. 4

DREDGE/EXCAVATOR JAY CASHMAN
WORK AREA
LHCC CONTAINMENT BERM

SCOWS
PATRIOT 144
TMC 140
AGM 1501
DEWATERING BARGE
DANA 55 - MATERIAL BARGE



FOTH INFRASTRUCTURE &
ENVIRONMENT, LLC
15 CREEK ROAD
MARION, MA 02738

NEW BEDFORD & FAIRHAVEN
CAD CELL NO. 4 & HARBOR DREDGE

52 FISHERMEN'S WHARF
NEW BEDFORD, MA 02740
NEW BEDFORD PORT AUTHORITY

DATE:	05/18/2020
SCALE:	1" = 500'
DRAWN BY:	PSR
CHECKED BY:	SEN
JOB NO.:	018N020
SHEET TITLE	
CAD CELL NO. 4 & HARBOR DREDGING WORK PROGRESS	
DRAWING NO.	
FIGURE 1	